




interior planning
+ design

124 lakefront drive
hunt valley, md 21030
410.785.7795

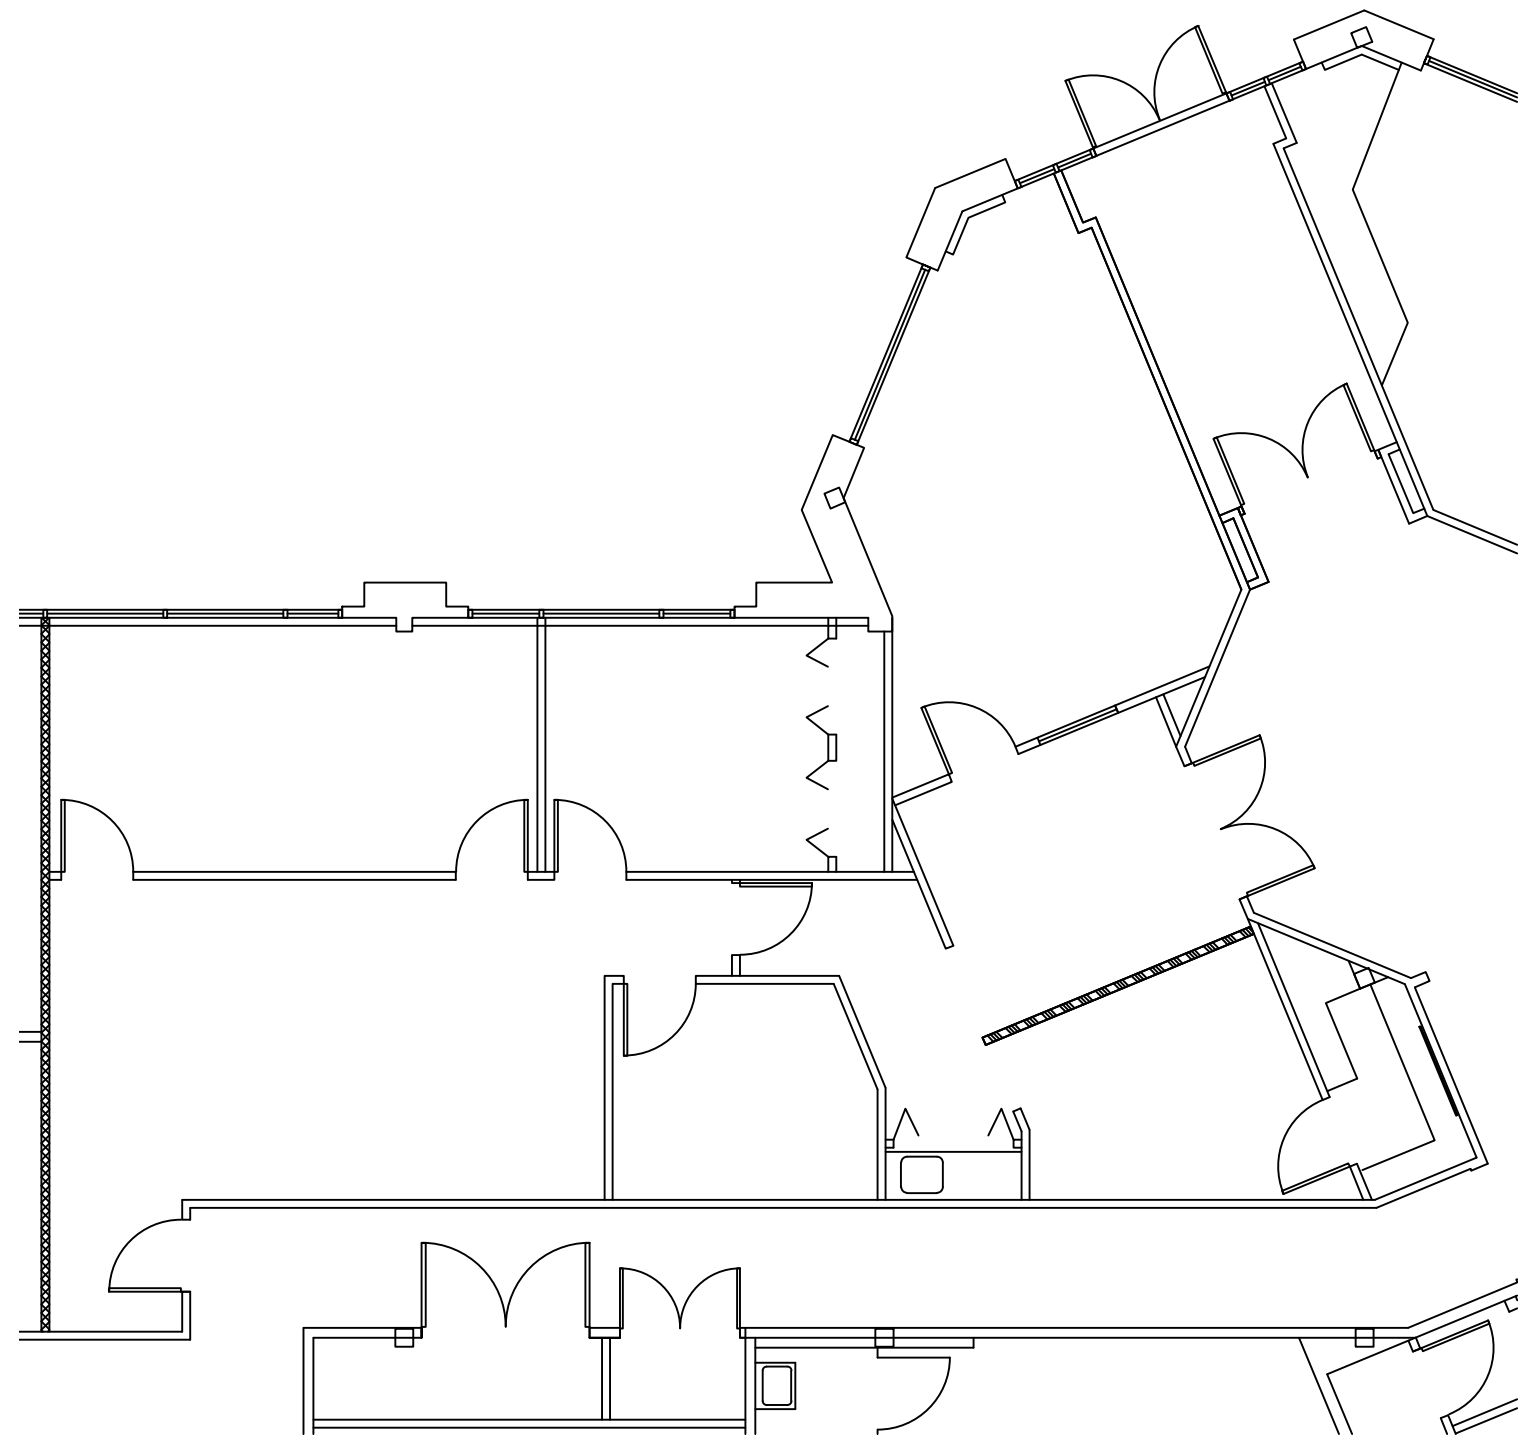

1 AS BUILT
ID-1 1/8"=1'-0"

NOTES:
THIS DRAWING IS FOR INFORMATIONAL AND REFERENCE PURPOSES ONLY. IT IS NOT FOR PRICING OR CONSTRUCTION PURPOSES. THIS SPACE HAS NOT BEEN FIELD VERIFIED BY NFD.

1302 CONCOURSE DRIVE
SUITE 103
LINTHICUM HEIGHTS, MARYLAND
AS BUILT

APPROVALS:	
DATE	BY

THESE DRAWINGS ARE PROTECTED UNDER THE COPYRIGHT ACT OF 1976 AND SHALL NOT BE REPRODUCED WITHOUT THE WRITTEN PERMISSION OF NFD, INC.

NOT FOR CONSTRUCTION

REVISIONS:			
#	DATE	DESCRIPTION	BY

DATE: 6/8/17
 SCALE: 1/8"=1'-0"
 DRAWN BY: AD
 DESIGN BY: AD
 CHECKED BY: SG
 PROJECT #: JG000

ID.1